

TECNIMONT

4274_CONST

ALBA PROJECT-PP AND PEL PLANTS



Tecnímont S.p.A.

MOD-ITP-XL_220		RELEASE OF SPOOLS FROM WORKSHOP	Report n° IP-WSR-P-310-000224_RFI3591_MOD-ITP-XL_220
Rev.1			RFI Nr.: Date :
Unit	-		
Plant Area	-		
Isometric Number			
Inspection Package Number	IP-WSR-P-310-000224_RFI3591 - IP Spool Release From Workshop		

Sheet 01/01

The Present Inspection Package contains the following Elements:

2121-CYG40B01-4-SP02;2121-CYG40B01-4-SP01;2211-PE41B03-3-SP10;2211-PE41B03-3-SP09;2211-PE41B03-3-SP08;2211-PE41B03-3-SP07;2121-CYG40C05-5-SP10;2121-CYG40B03-1-SP02;2121-CYG40B03-1-SP01;2121-CYG40B02-2-SP03

Spool No.	Ready for destination to: P: Painting (1) W: Wrapping F: Field	NDE Class	Check List					
			Visual Inspect	Traceability OK (2)	Pending NDE / PMI (Yes/No/NA)	PWHT / HARDNESS (Yes/No/NA)	Inside Cleaning (3) (Yes/No/NA)	Spool Identified (Yes/No/NA)

Ion Dragos Andrei
23.07.2024
On behalf of TCM

SGS
N. Br. 1153 witness
25/07/2024

ZEGHEANU ADRIAN
23/07/2024
ON BEHALF OF TCM

LEGEND OF CHECK RESULT	<input checked="" type="checkbox"/> Checked & NOT Accepted	<input type="checkbox"/> Checked & Accepted	N.A. Not Applicable	Y/N Punch List Produced
SUBCONTRACTOR	Date [DD-MMM-YYYY]	Name		Signature
CONTRACTOR	23.7.24	2024 CMC		
COMPANY				QC
(Free)				



Punch List

PUNCH LIST

IDENTIFICATION CODE

SHEET
1 /

DOC.CLASS
1

ISSUE
01



ISO ID: 2121 - CYG40B02 - 2

Ion Dragos Andrei
23.07.2024.
On behalf of TCM


NOTES AND REMARKS

~~ZEGHEBOUW A~~
Dok 23/07/2024
~~BENADE OF TOLY~~

	DATE (dd-Mmm-YYYY)	NAME	SIGNATURE
SUBCONTRACTOR			
CONTRACTOR			
COMPANY			
(Free)			

Tecniplast		PLANT: SINES INDUSTRIAL COMPLEX		PIPING ISOMETRIC		IDENTIFICATION CODE	
		CLIENT REF: REPSOL POLIMEROS		Job #:	4274	ELCTN Area	N
				UNIT	19	SHEET#	2 / REV 00
E	C	N	N	E/C	N		
Piping support drawing		[S1-140203-000659 sheet 1 of 1]		Piping support specification		XH-Su-000000002	Piping standard support summary
Piping isometric list		[XH-ID-2710001]		Piping typical installations		XH-PI-000000001	Welding specification

MIRO2

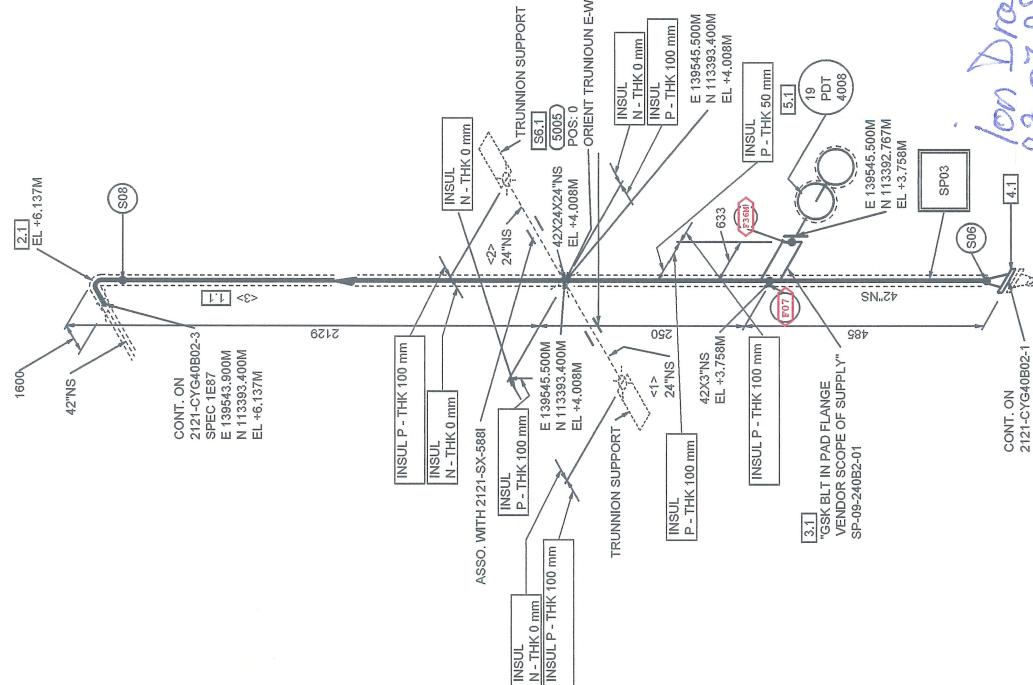

-000-

AUTHORISED FOR CONSTRUCTION


100 | *THE JOURNAL*

973

This document is Technimort's property, and cannot be used by others for any purpose without prior written consent.

BILL OF MATERIALS							
FABRICATION MATERIALS				ERCTION MATERIALS			
PS NO	DESCRIPTION	NS (MM)	ITEM CODE	NS (MM)	ITEM CODE	QTY.	HOLD
1	EPIPE PIPE - A6971-CG60 BE EFW CL22 SUPPL. REQ. S2 T01AC27V10 S-20.62 EFTINGS <PIPA0308V1A20312> (L-PPI19)	42	I63726232			1.1 M	
2	90° LR ELBOW ASME B16.9 A420-WP16 BE WELD COIDC05W102 S-20.62 <90LR1WMP16A20312> (L-SP15CPW)	42	I7519062			1	
3	SPECIALTY COMPONENT	3	SIP-69-4082-01			1	
4	ELANGLES WN FLANGE ASME B16.47-B 300# A105N REFL BE 125 - 250 AARH FO1MFC4ABW05 S-20.62 <4WNA50093420> (L-8916)	42	I63598454			1	
PS NO	DESCRIPTION	NS (MM)	ITEM CODE	NS (MM)	ITEM CODE	QTY.	HOLD
5	INSTRUMENT COMPONENT 19BDTH008	3				1	
6	SUSPENDED SPECIALTY SUPPORT - SP-022	42	S005			1	
CUT LIST	WELD LIST	WELD LIST	WELD LIST	BOLT NO	BOLT TYPE	FLANGE SIZE(IN)	LENGTH (MM)
PIECE NO	WELD NO	WELD CAT.	SIZE (IN)				
<1>	1055	42"	S				
	606 607	606 607	42"	BW			
	608 609	608 609	3"	SIB			
	S08	S08	3"	SIB			
			42"	BW			
INCH METER							
PIPE INS (IN)				CL LENGTH (M)			
42				3			
ISOMETRIC NO. 4274-SP-XH-HL-2121-CY/G010802-2-S00				SPOOLING REV NO. 00			

SHEET NO. 1 OF 1

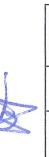

1

AUTHORISED FOR CONSTRUCTION

DIGNED FOR CONSTRUCTION IS SHOWN ON ISO LIST FOR RELEVANT PIPING AREA

15